



DETAIL 1

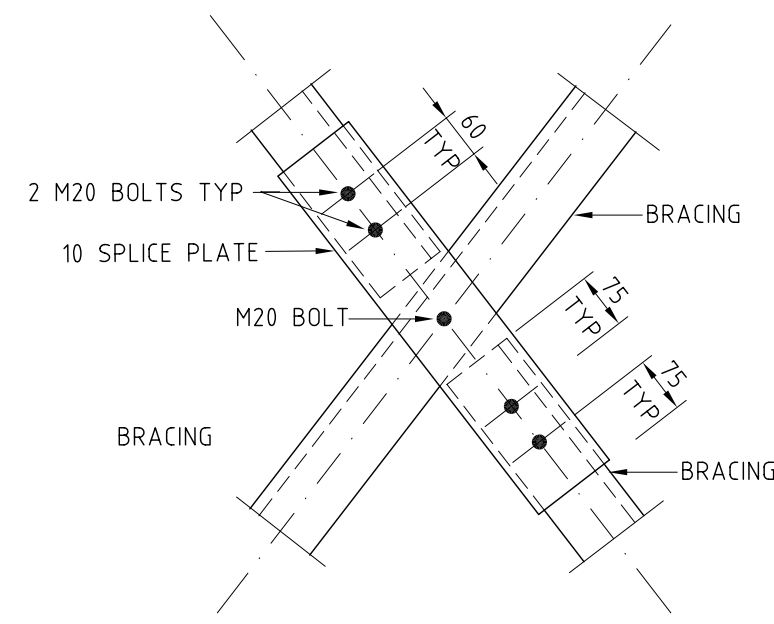


TYPICAL BRACING DETAIL

DETAIL 2

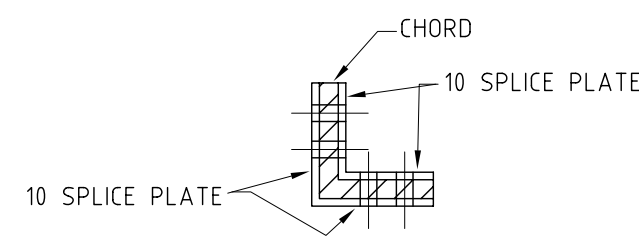


SECTION

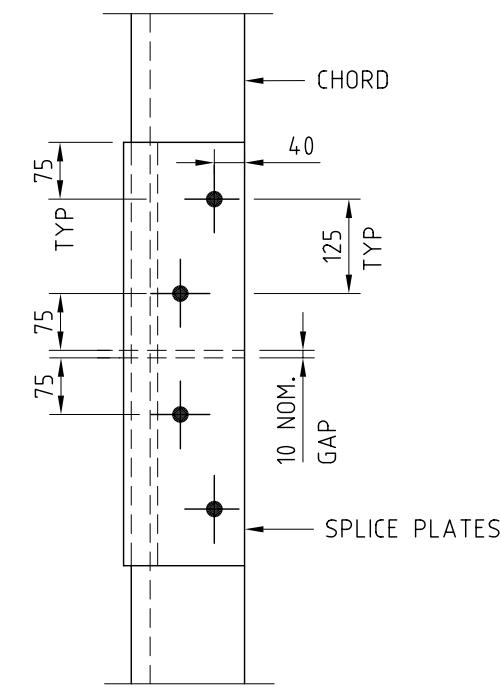


ELEVATION


DETAIL 3

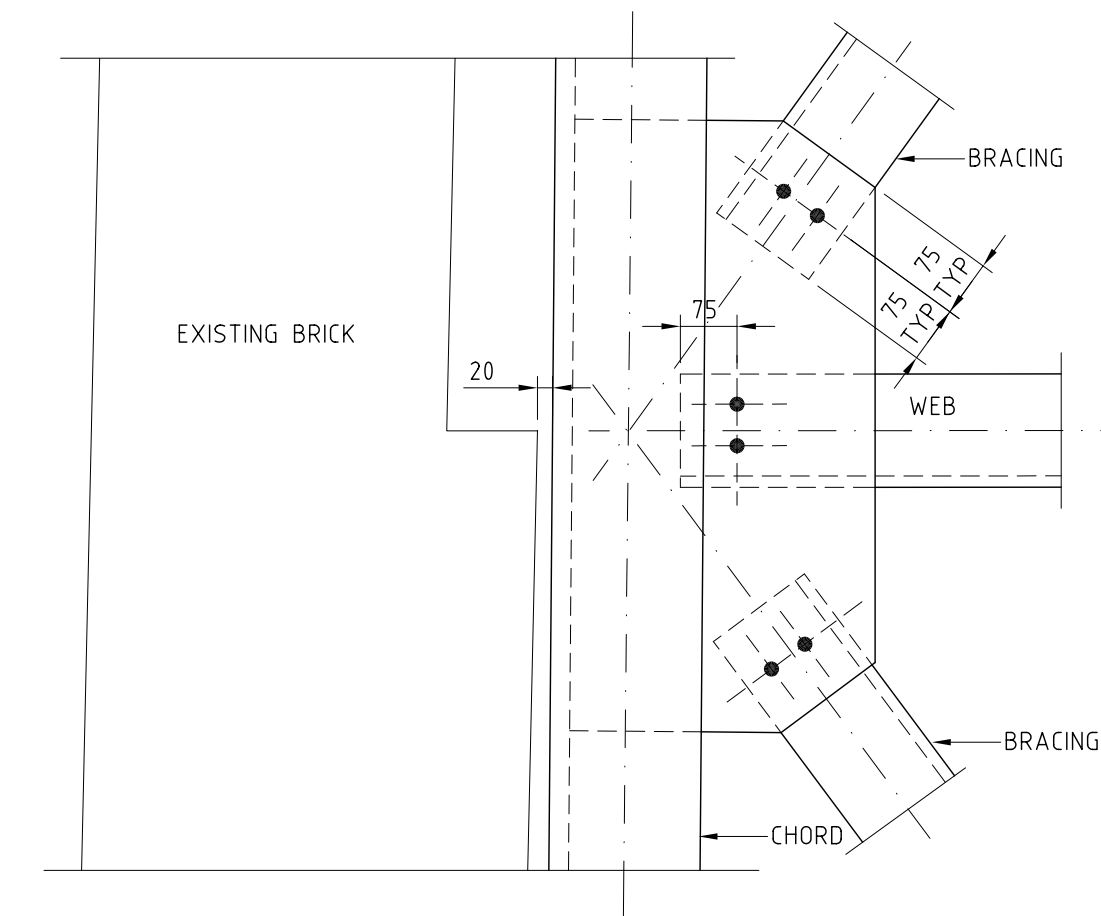


DETAIL 4

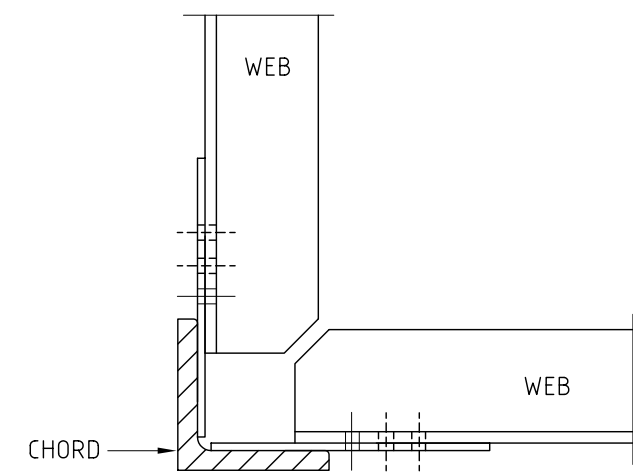


SECTION 5

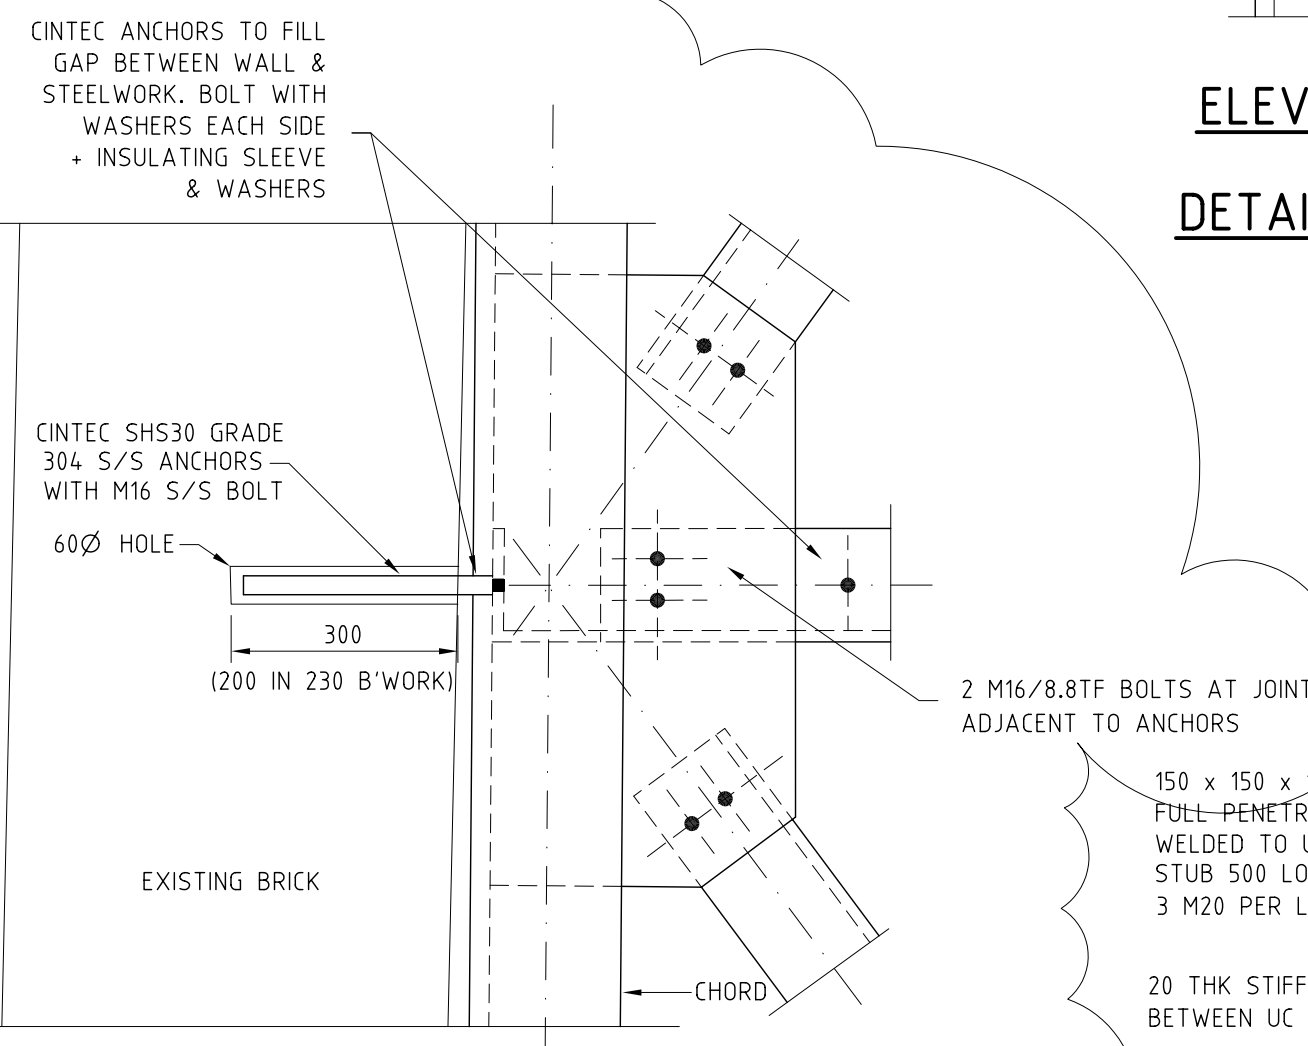


DETAIL 6

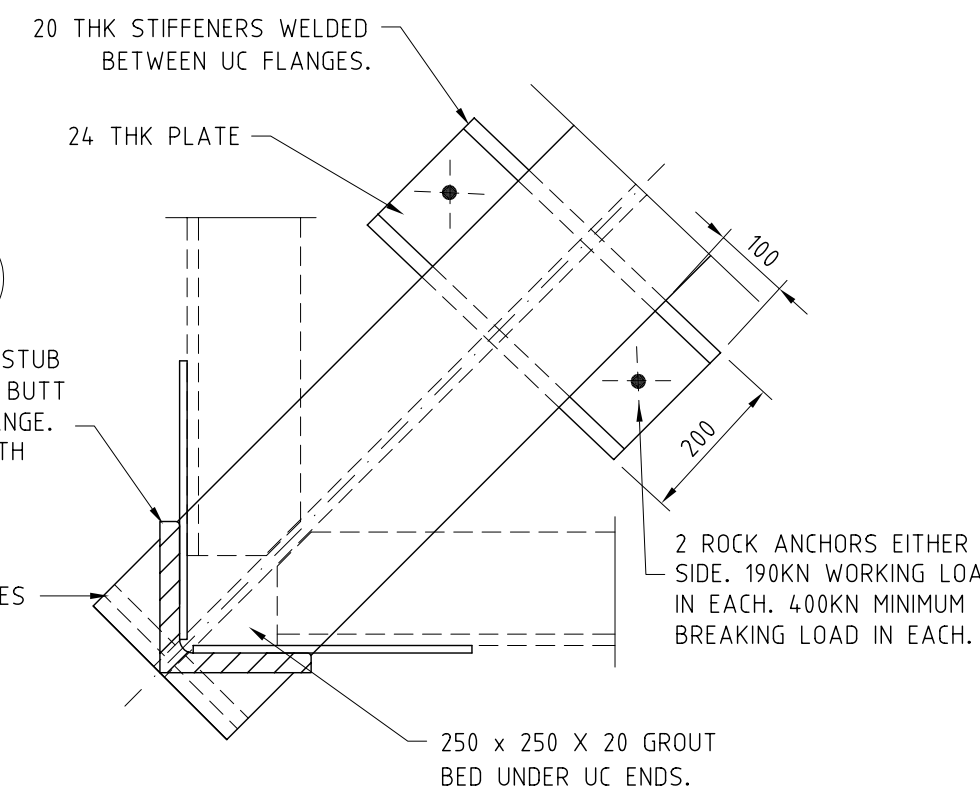

SECTION 7

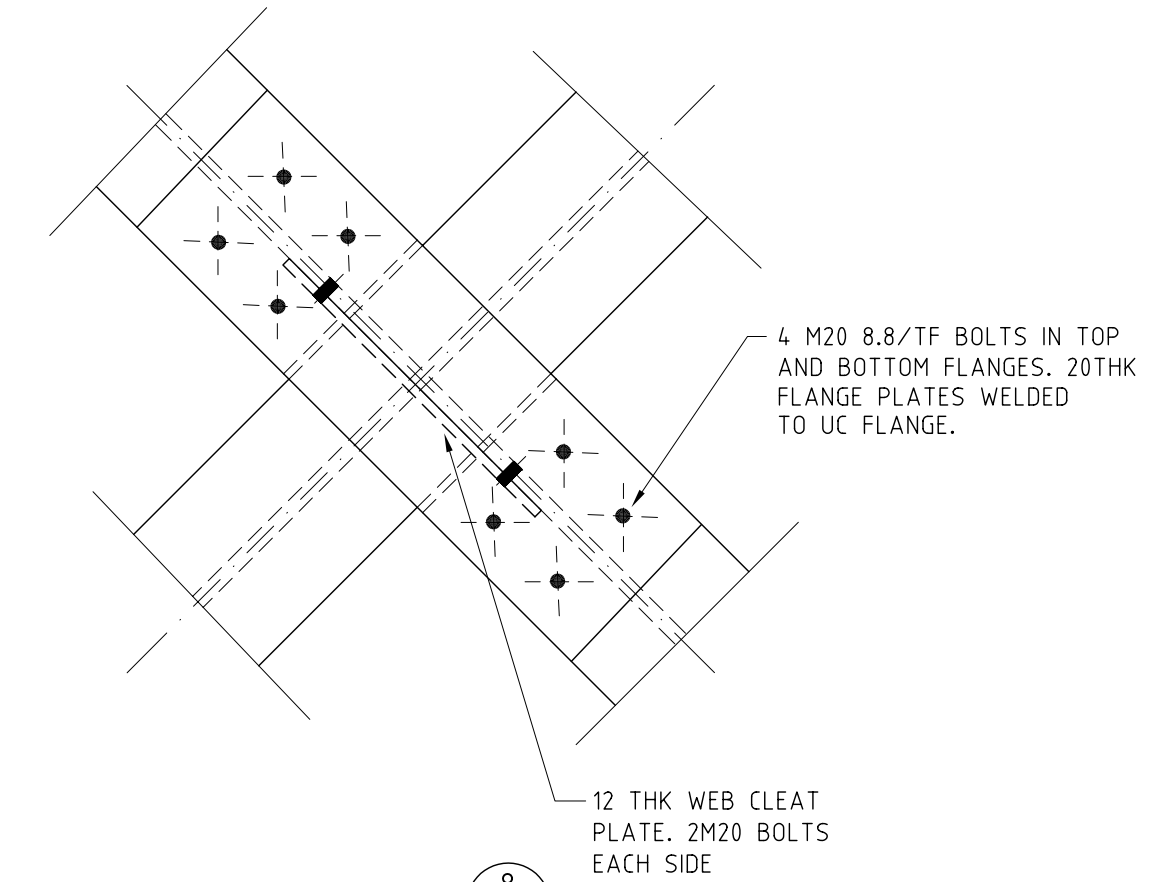

DETAIL 8

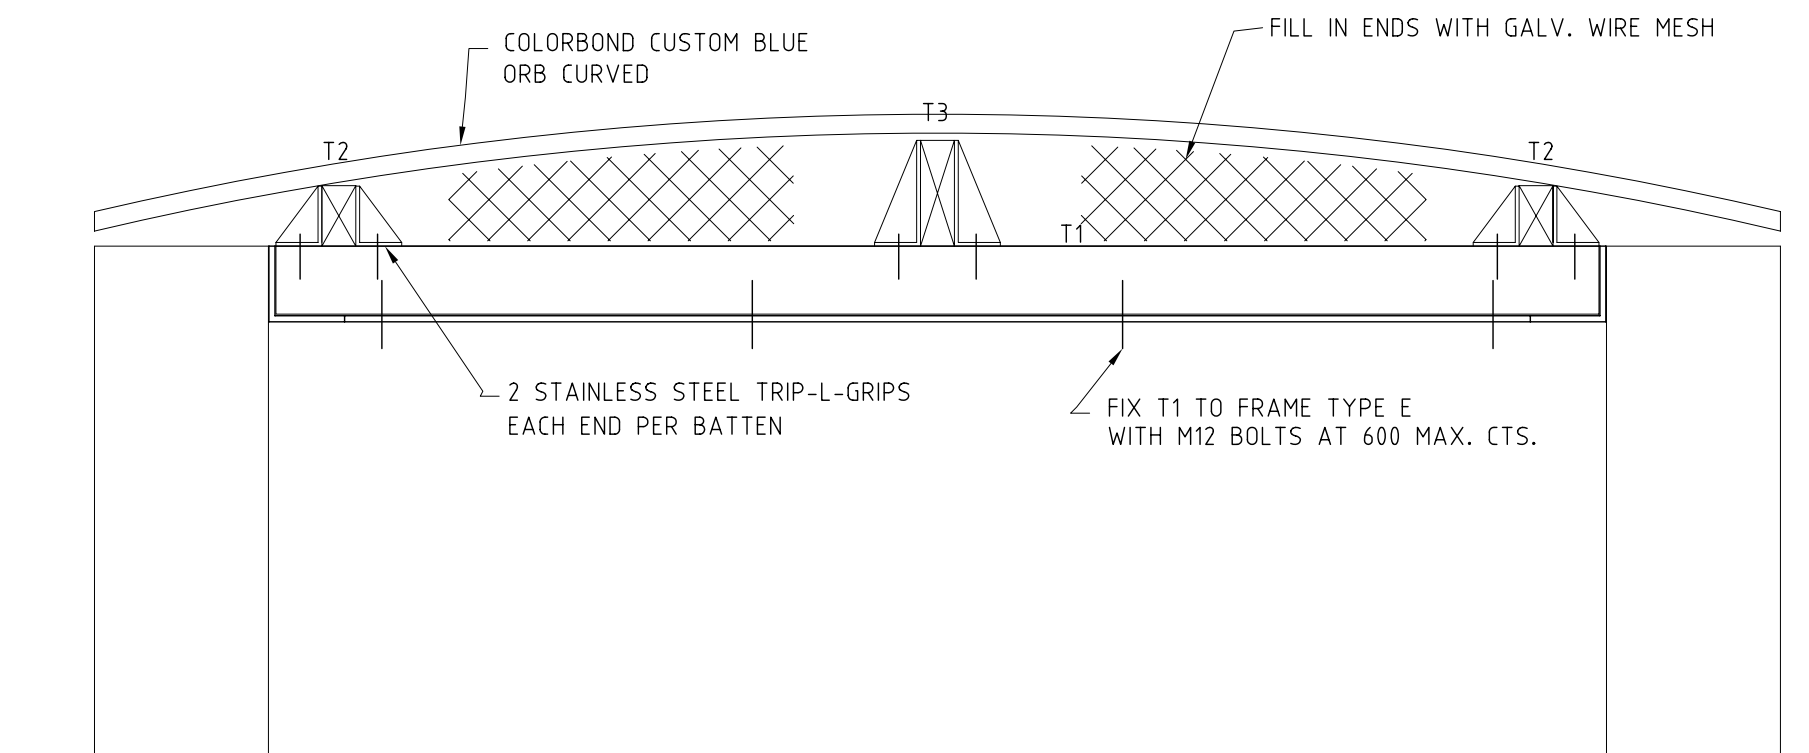

SECTION D/S01

MARK	DATE	AMENDMENT
G	29/04/03	DETAIL 6 MODIFIED
F	26/03/03	DETAIL 8 MODIFIED
E	14/02/03	ISSUED FOR CONSTRUCTION
D	08/05/02	ISSUED FOR COMMENT
C	03/05/02	ISSUED FOR COMMENT
B	28/03/02	ISSUED FOR COMMENT

COPYRIGHT This drawing remains the property of Bill Jordan & Associates Pty Ltd. It may only be used for the purpose for which it was commissioned & in accordance with the terms of engagement of that commission. Unauthorized use of this drawing is prohibited.

DRAWING STATUS Unless there is an authorized signature in **coloured ink** below, this drawing is not to be issued for construction.

NORTH

ACEA Bill Jordan & Associates Pty Ltd
 A.C.N. 003 320 652
 Chartered Civil & Structural Engineer
 PO Box 141, Newcastle NSW 2300
 Ph.: (02) 4929 4841; Fax: (02) 4929 7933

SIGNED: J.W. JORDAN FIEAust, CPEng, NPER Reg. No. 161488

PROJECT
 YARRALUMLA BRICKWORKS
 CHIMNEY S3

THIS DRAWING
 CHIMNEY SUPPORT
 STRUCTURAL DETAILS SHEET 2

CLIENT
 ACT URBAN SERVICES

SCALE	DATE	PROJECT No.	
1:10	03-05-02	J023	
DRAWN	CHECKED	SHEET No.	AMENDMENT
HSW	AJ	S02	G